

OFFICIAL

Melbourne Water Submission to Croskell Employment PSP - Public Consultation (October 2024)

Appendix A – Images referenced in submission

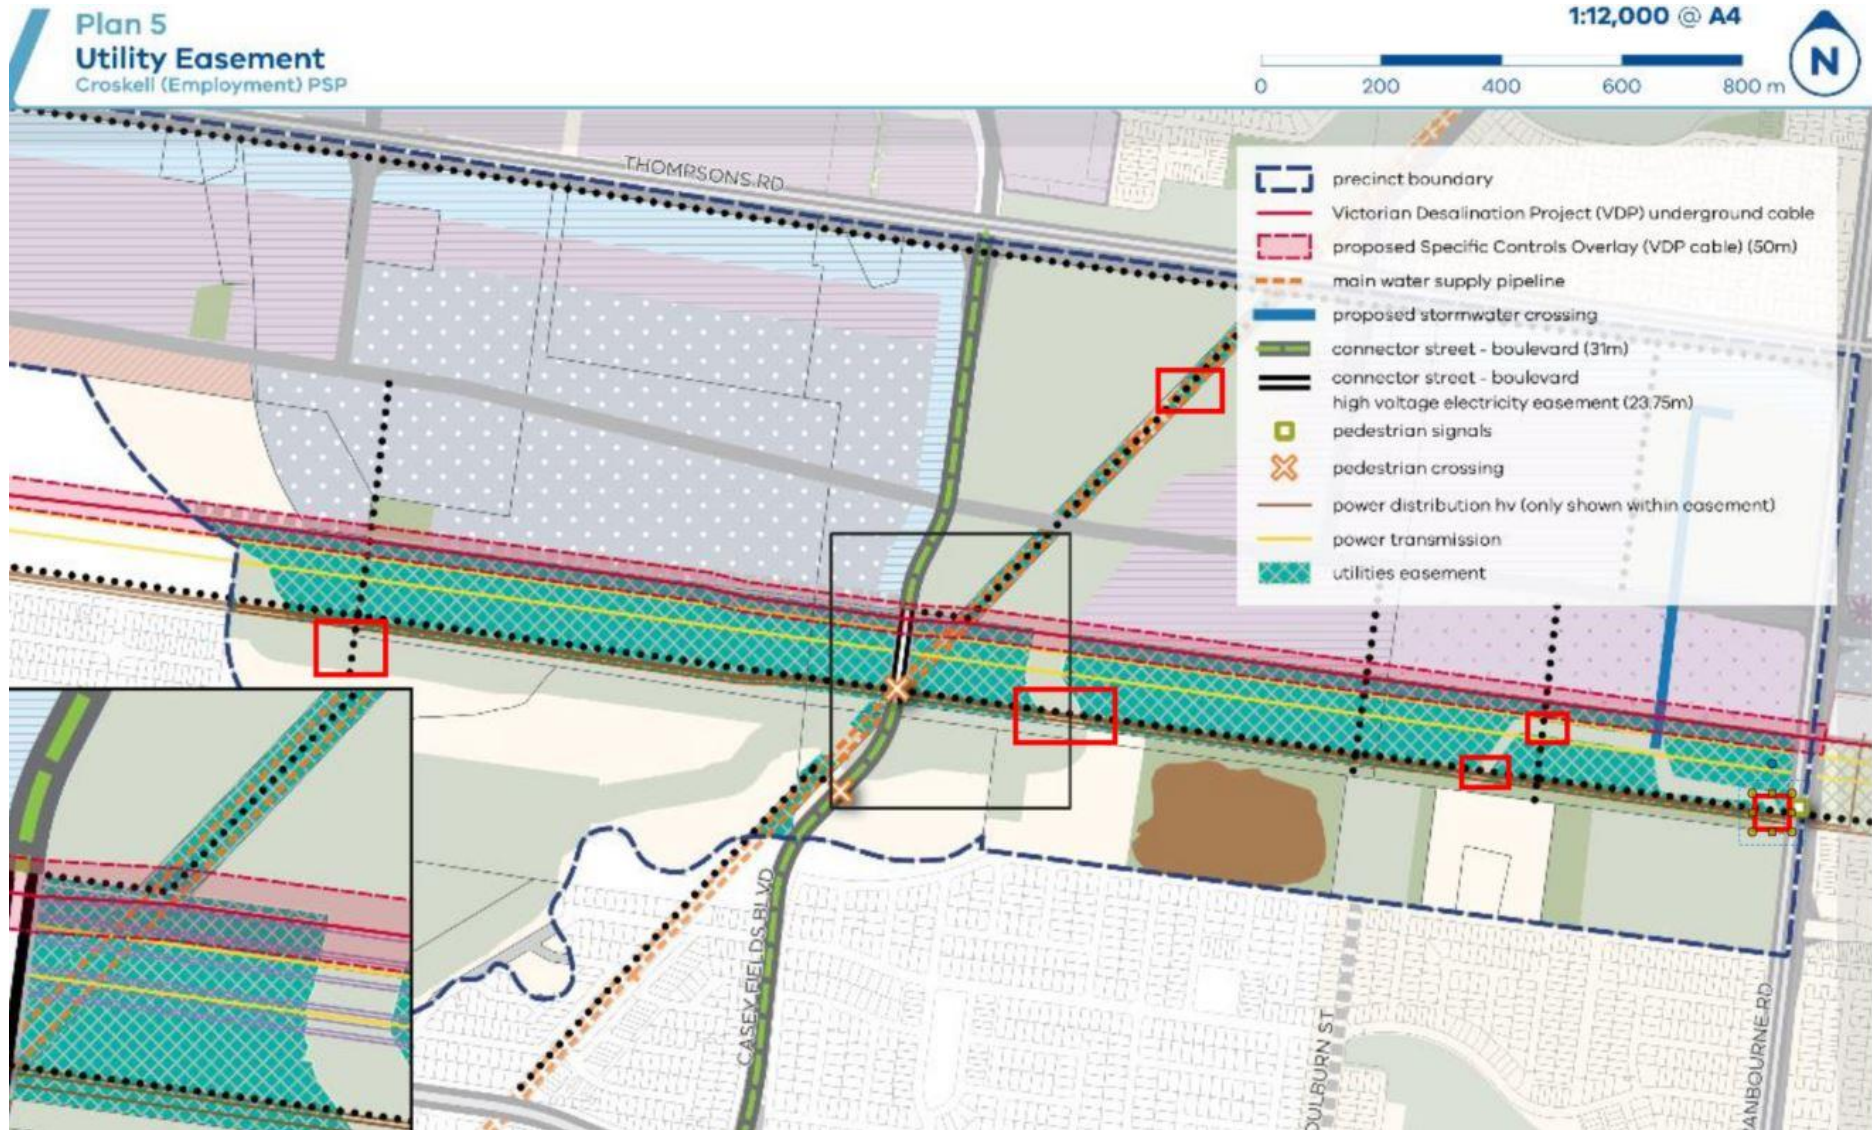


Image 1 – Pedestrian crossings of waterway (shown red) for Plan 4 (Movement Networks and Public Transport) and Plan 5 (Utility Easement).

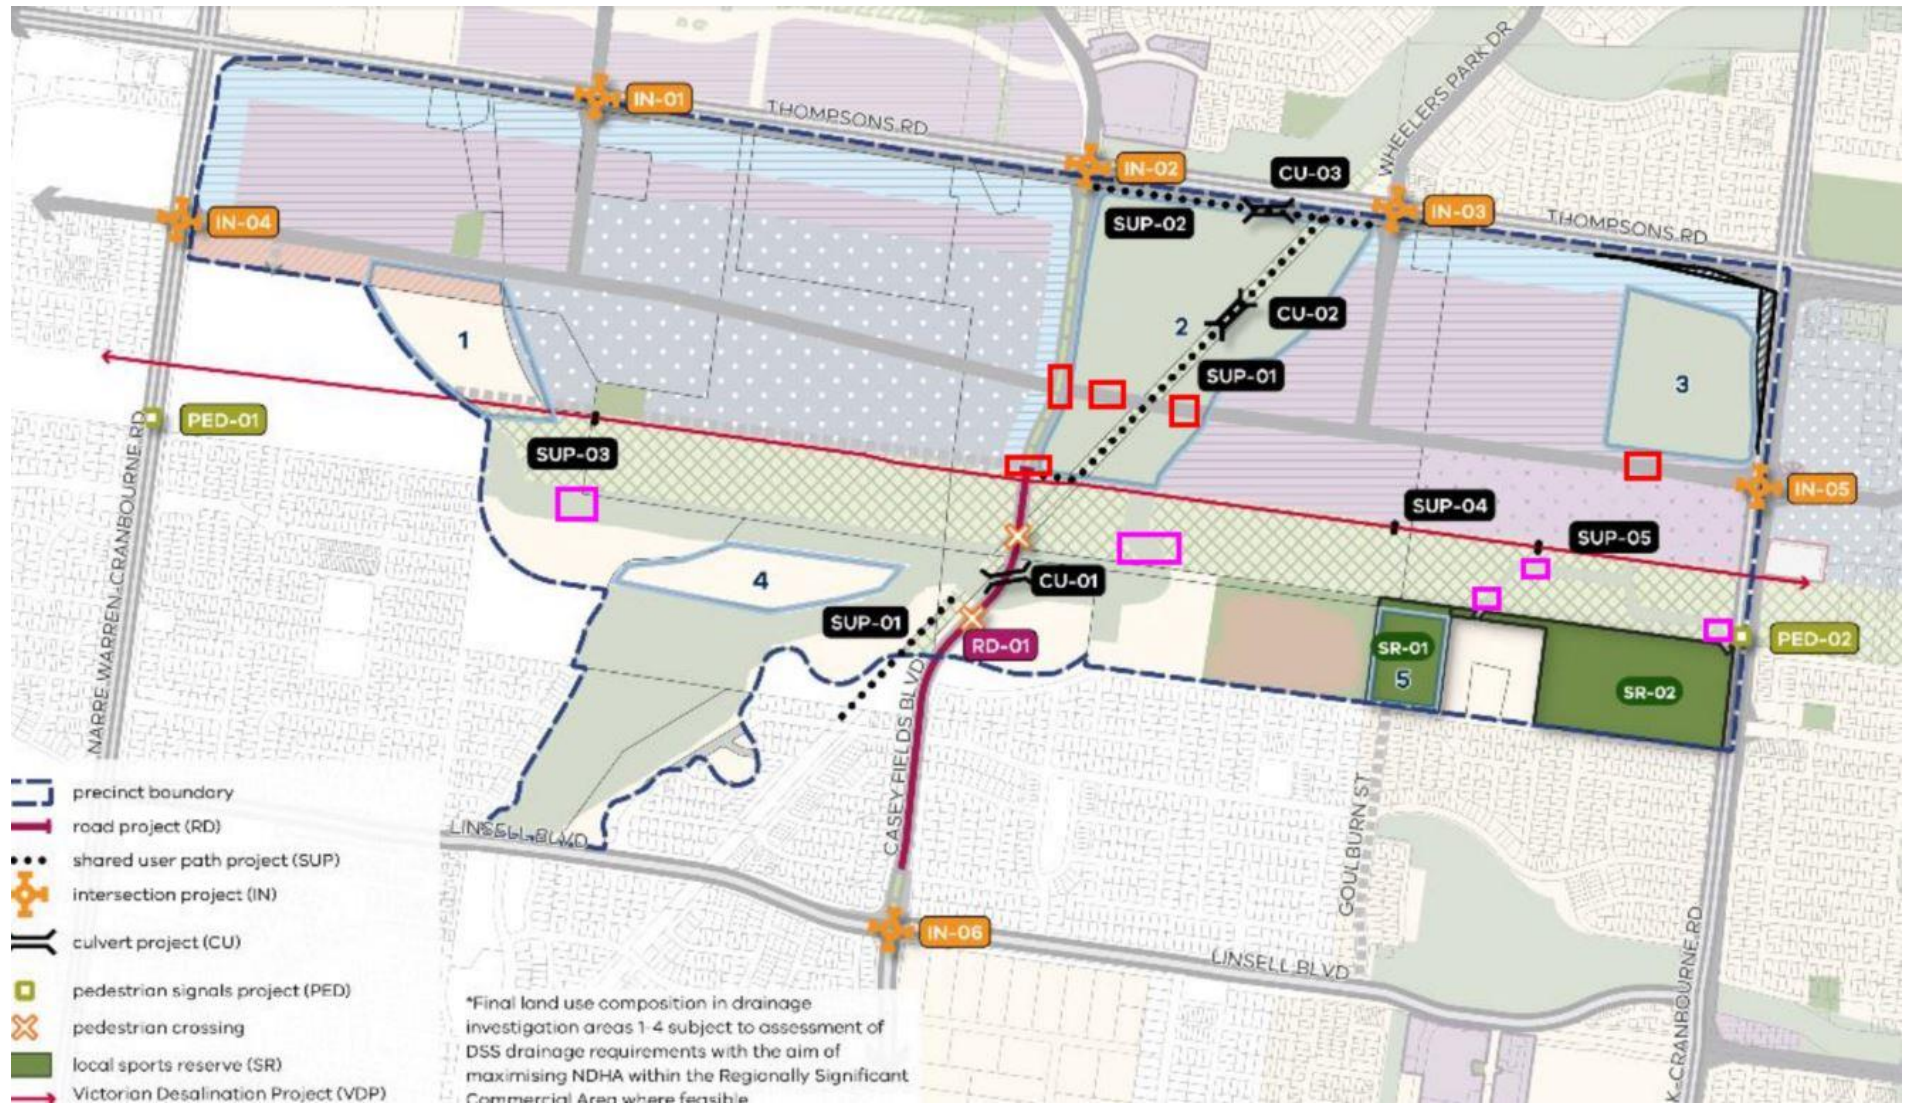


Image 2 – Road culvert locations (shown in red) and shared user path crossings (shown in pink) for Plan 4 (Movement Networks and Public Transport) and Plan 12 (Precinct Infrastructure Plan).



Image 3 – Major overland flow path (shown yellow) for Plan 7 - Public Realm and Water.